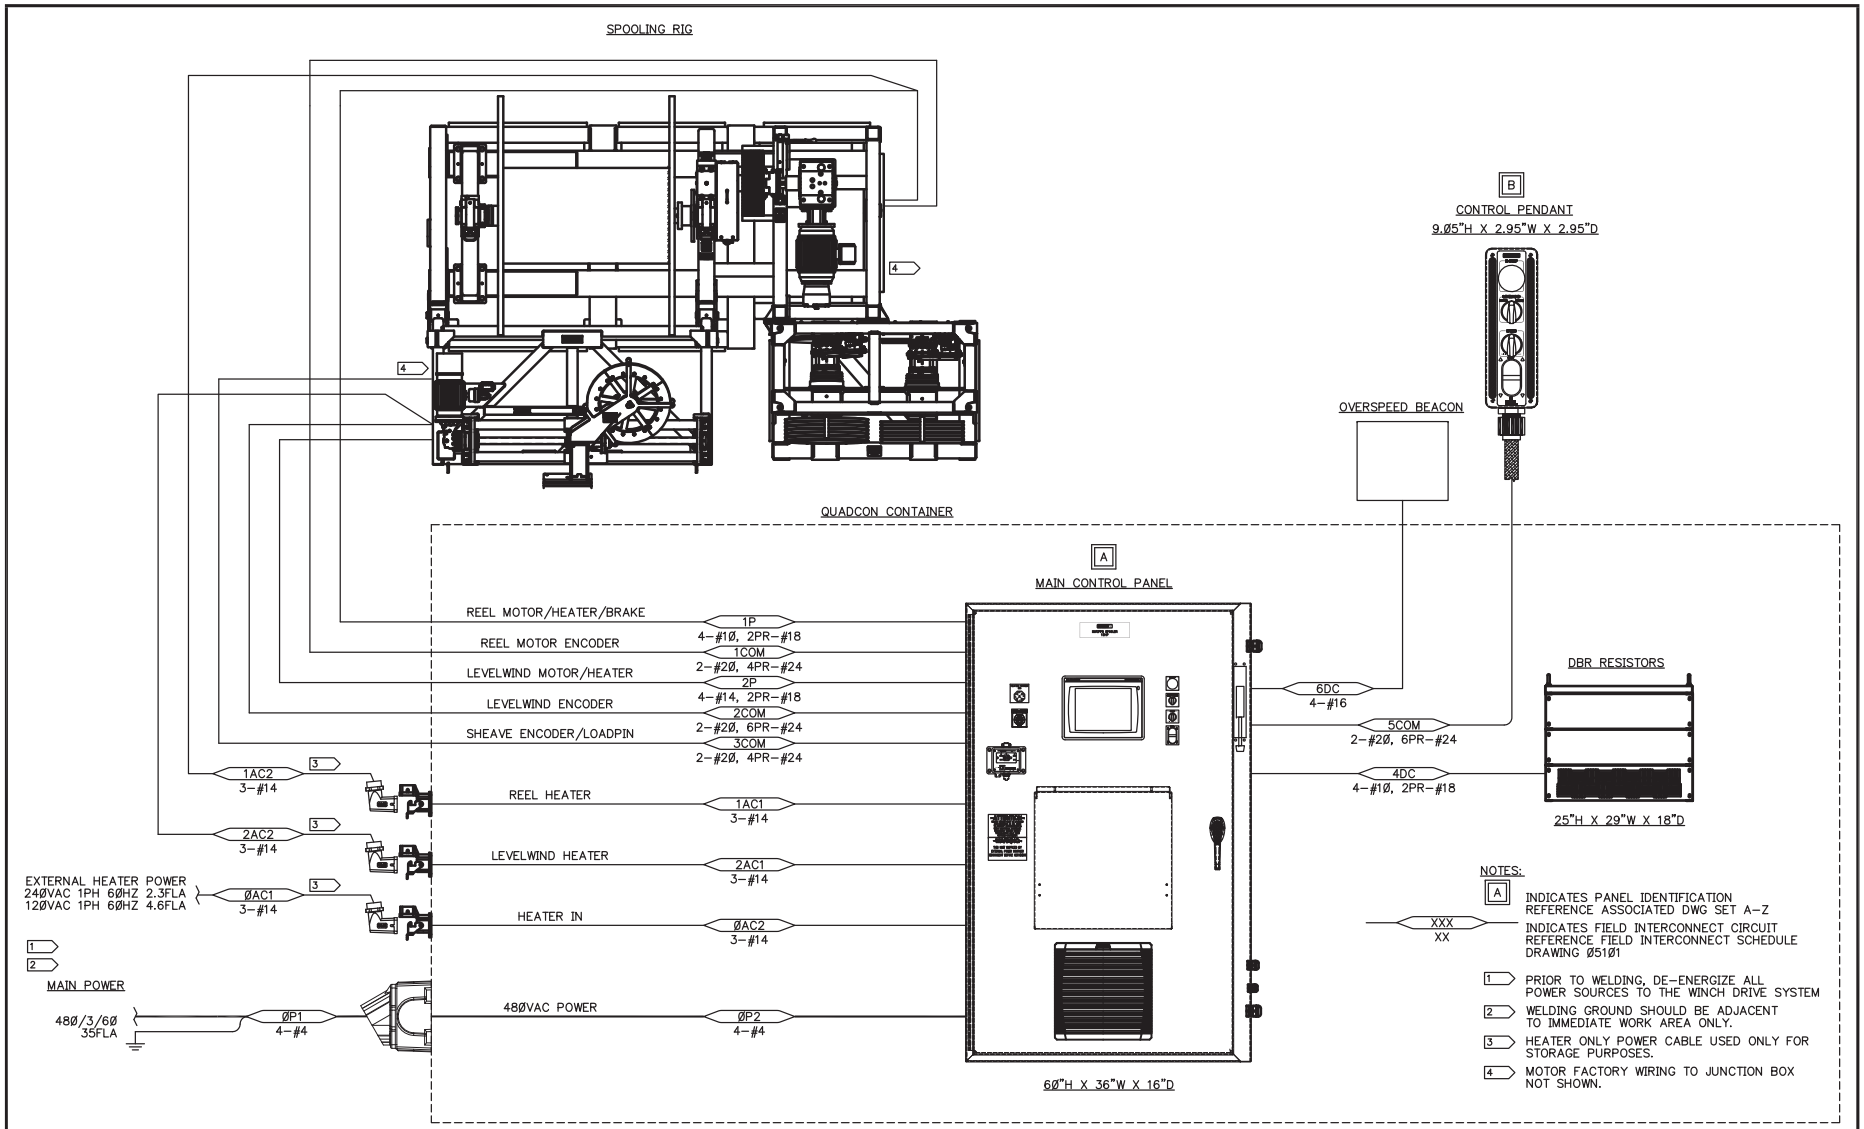


| SYM | REVISION RECORD | BY | DATE | SYM | REVISION RECORD | BY | DATE |
|---|---|---|---|---|---|---|---|
| 0 | ORIGINAL | JAC | 07-11-16 | | | | |
| 1 | AS BUILT | JAC | 10-05-16 | | | | |
| 2 | FINAL | JAC | 12-09-16 | | | | |
| 3 | OVERSPEED BEACON | JAC | 09-19-17 | | | | |

MARKEY

SEATTLE, WA., U.S.A. 98108 * (206) 622-4697 * FAX (206) 623-9839
www.markeymachinery.com

| | | DATE |
|---|---|---|
| DRAWN BY: | JAC | 07-11-16 |
| ENGINEER: | JAC | 07-11-16 |
| CHECKED: | | |
| APPROVED: | | |
| APPROVED: | | |

MARKEY MACHINERY INC.
SEATTLE, WA. 98108
SCRIPPS MODULAR SPOOLING RIG

SYSTEM
SYSTEM OVERVIEW

| LAST REVISION | DATE |
|---|---|
| | 09-19-17 |
| | SYMBOL |
| | 3 |

DRAWING NUMBER:
S16C85-01501